
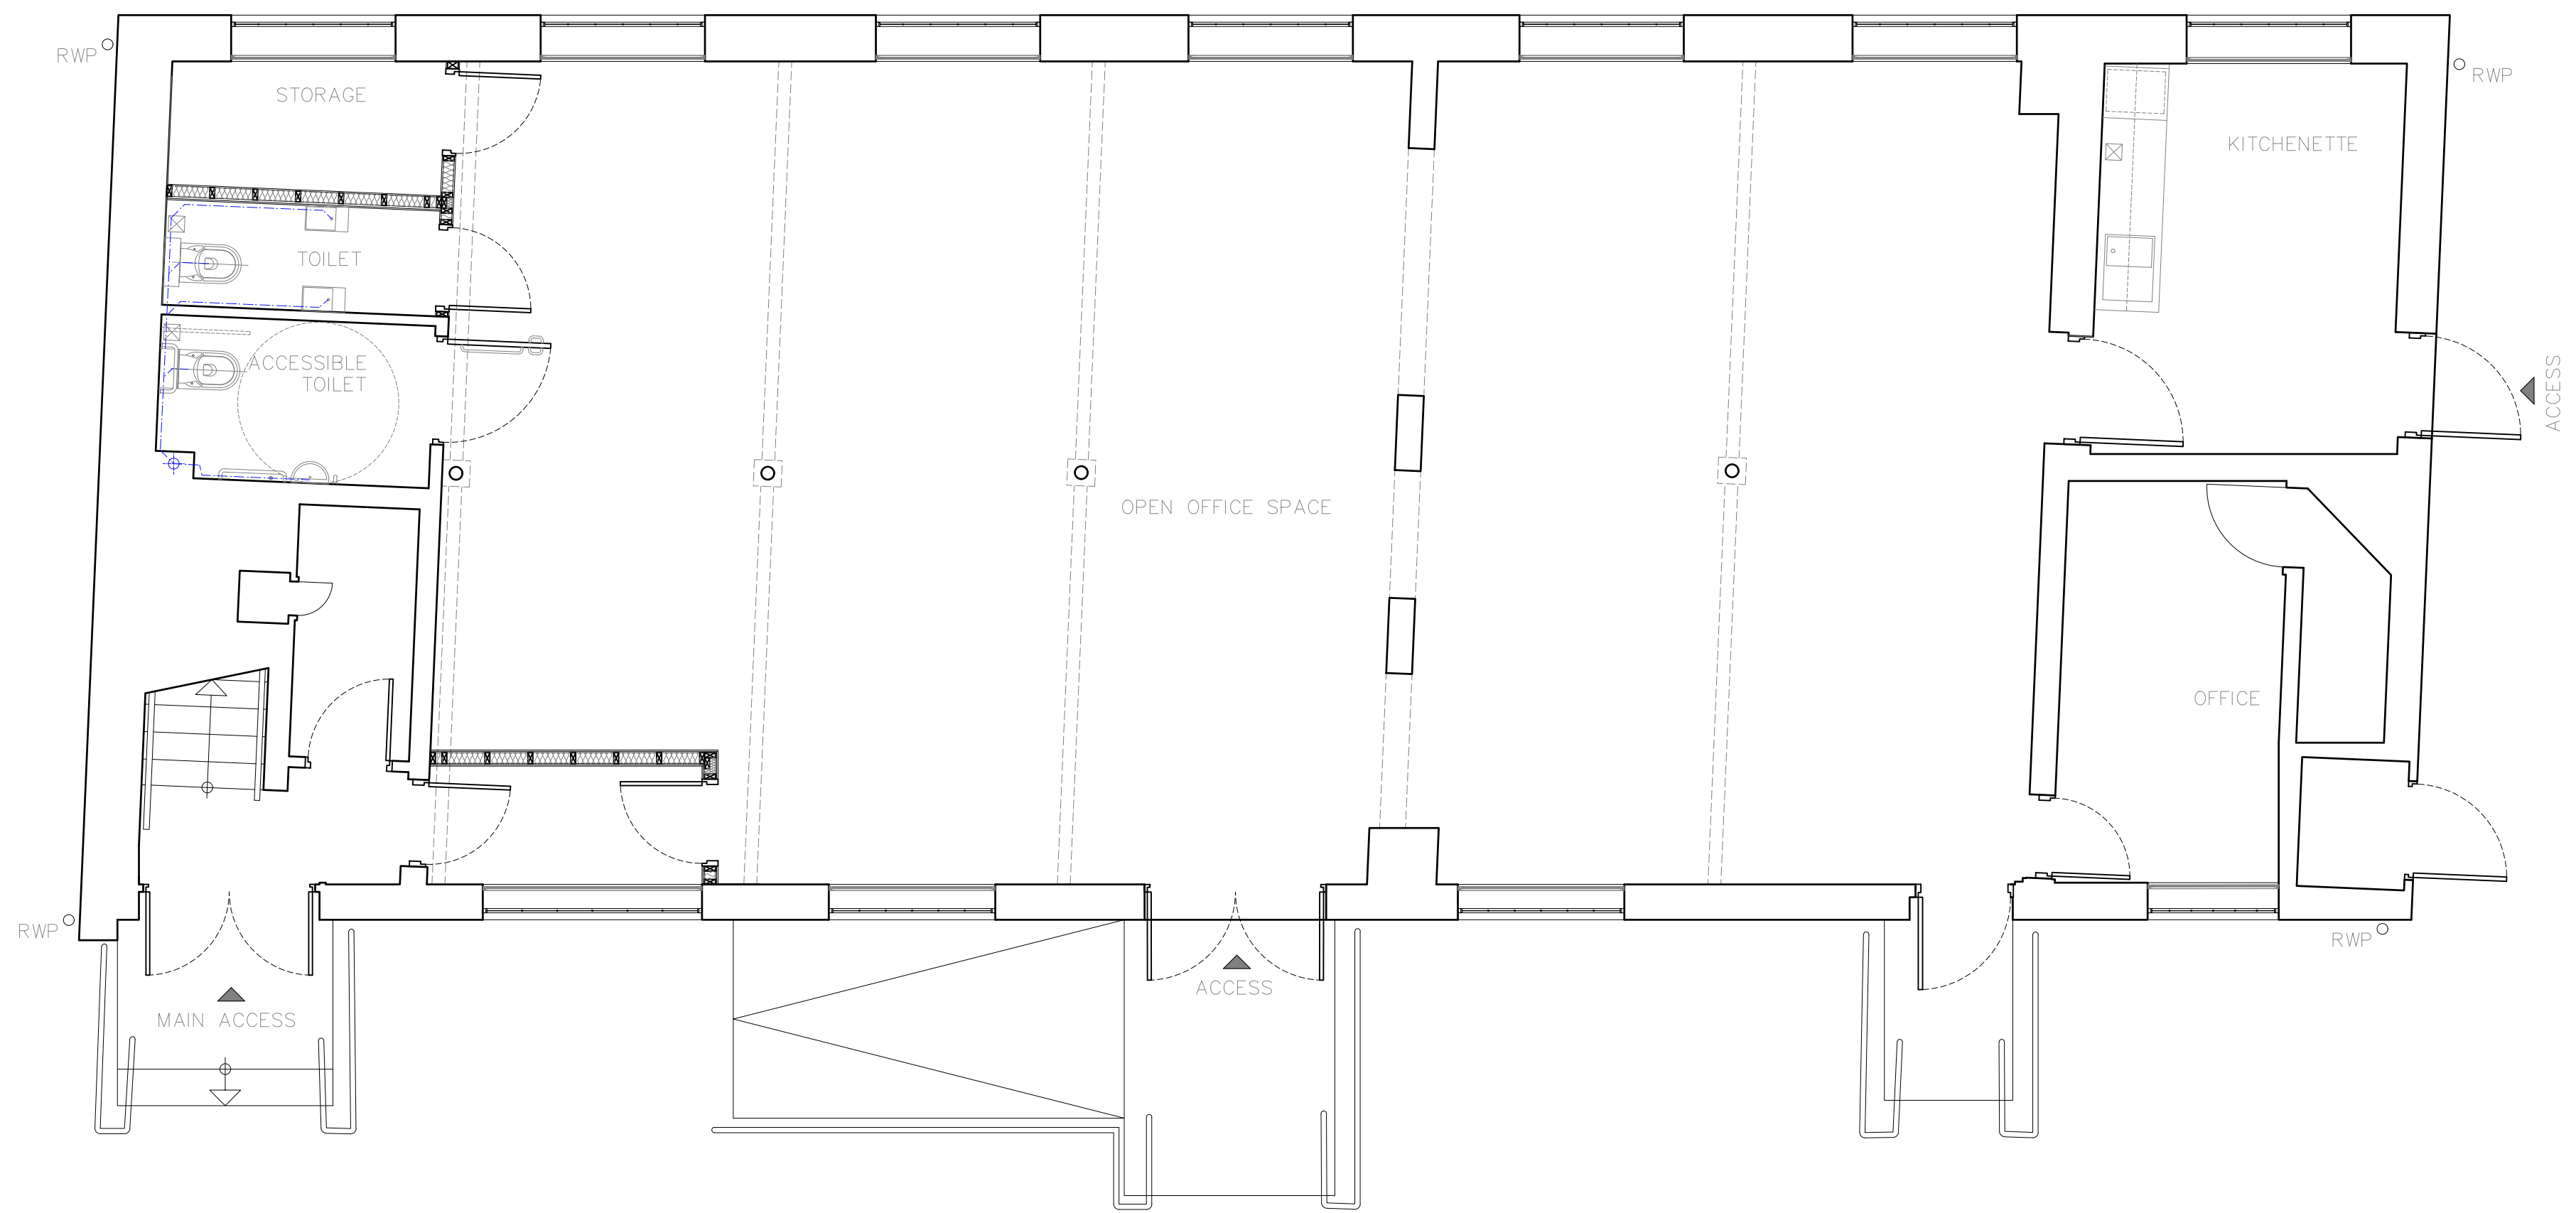


REV	REVISION DETAILS	DATE	DRW	CHK
T1	TENDER MANAGEMENT NOVATED TO KAA	--20	KA	KA

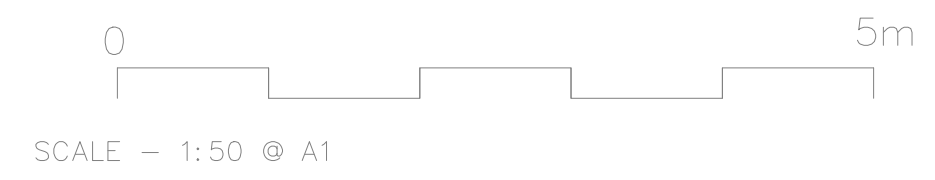

AS-BUILT DRAWING

PROJECT: THE MALTINGS
PROJECT ADDRESS: THE MALTINGS, BEAR WHARF, READING, RG1 6BT
CLIENT: MACNIVEN QUAYS LTD
PROJECT NUMBER: 0074
DRAWING NAME: GROUND FLOOR GA PLAN
ISSUE TYPE: AS BUILT
DRAWING NUMBER: 265-W-20
SCALE: 1 : 50
APPROVED BY: MARENGO PROJECTS
FIRST ISSUE DATE: --
DRAWN BY: KAA

General Notes
Do not scale from drawings. All dimensions must be checked on site and discrepancies verified with the Architect prior to construction. Unless shown otherwise all dimensions are to be structural surfaces and are in mm.
Unless shown refer to internal door schedule for door sizes.
Door openings to be set out to give full specified architrave either side.
To be read in conjunction with all relevant Architects', Services and Structural Engineers' drawings.
For all structural details and information refer to Structural Engineers drawings.
For all mechanical and electrical information refer to M&E consultants drawings and information unless shown otherwise.
Any discrepancies between drawings to be reported immediately to the architect as once built on site responsibilities are therefore withdrawn. Refer to drawing number for details and correspondence.

1 GROUND FLOOR GA PLAN
1:50



13 The Avenue
Ealing
London
W13 8JR
+44 (0) 845 489 0629
hello@marengoprojects.com