
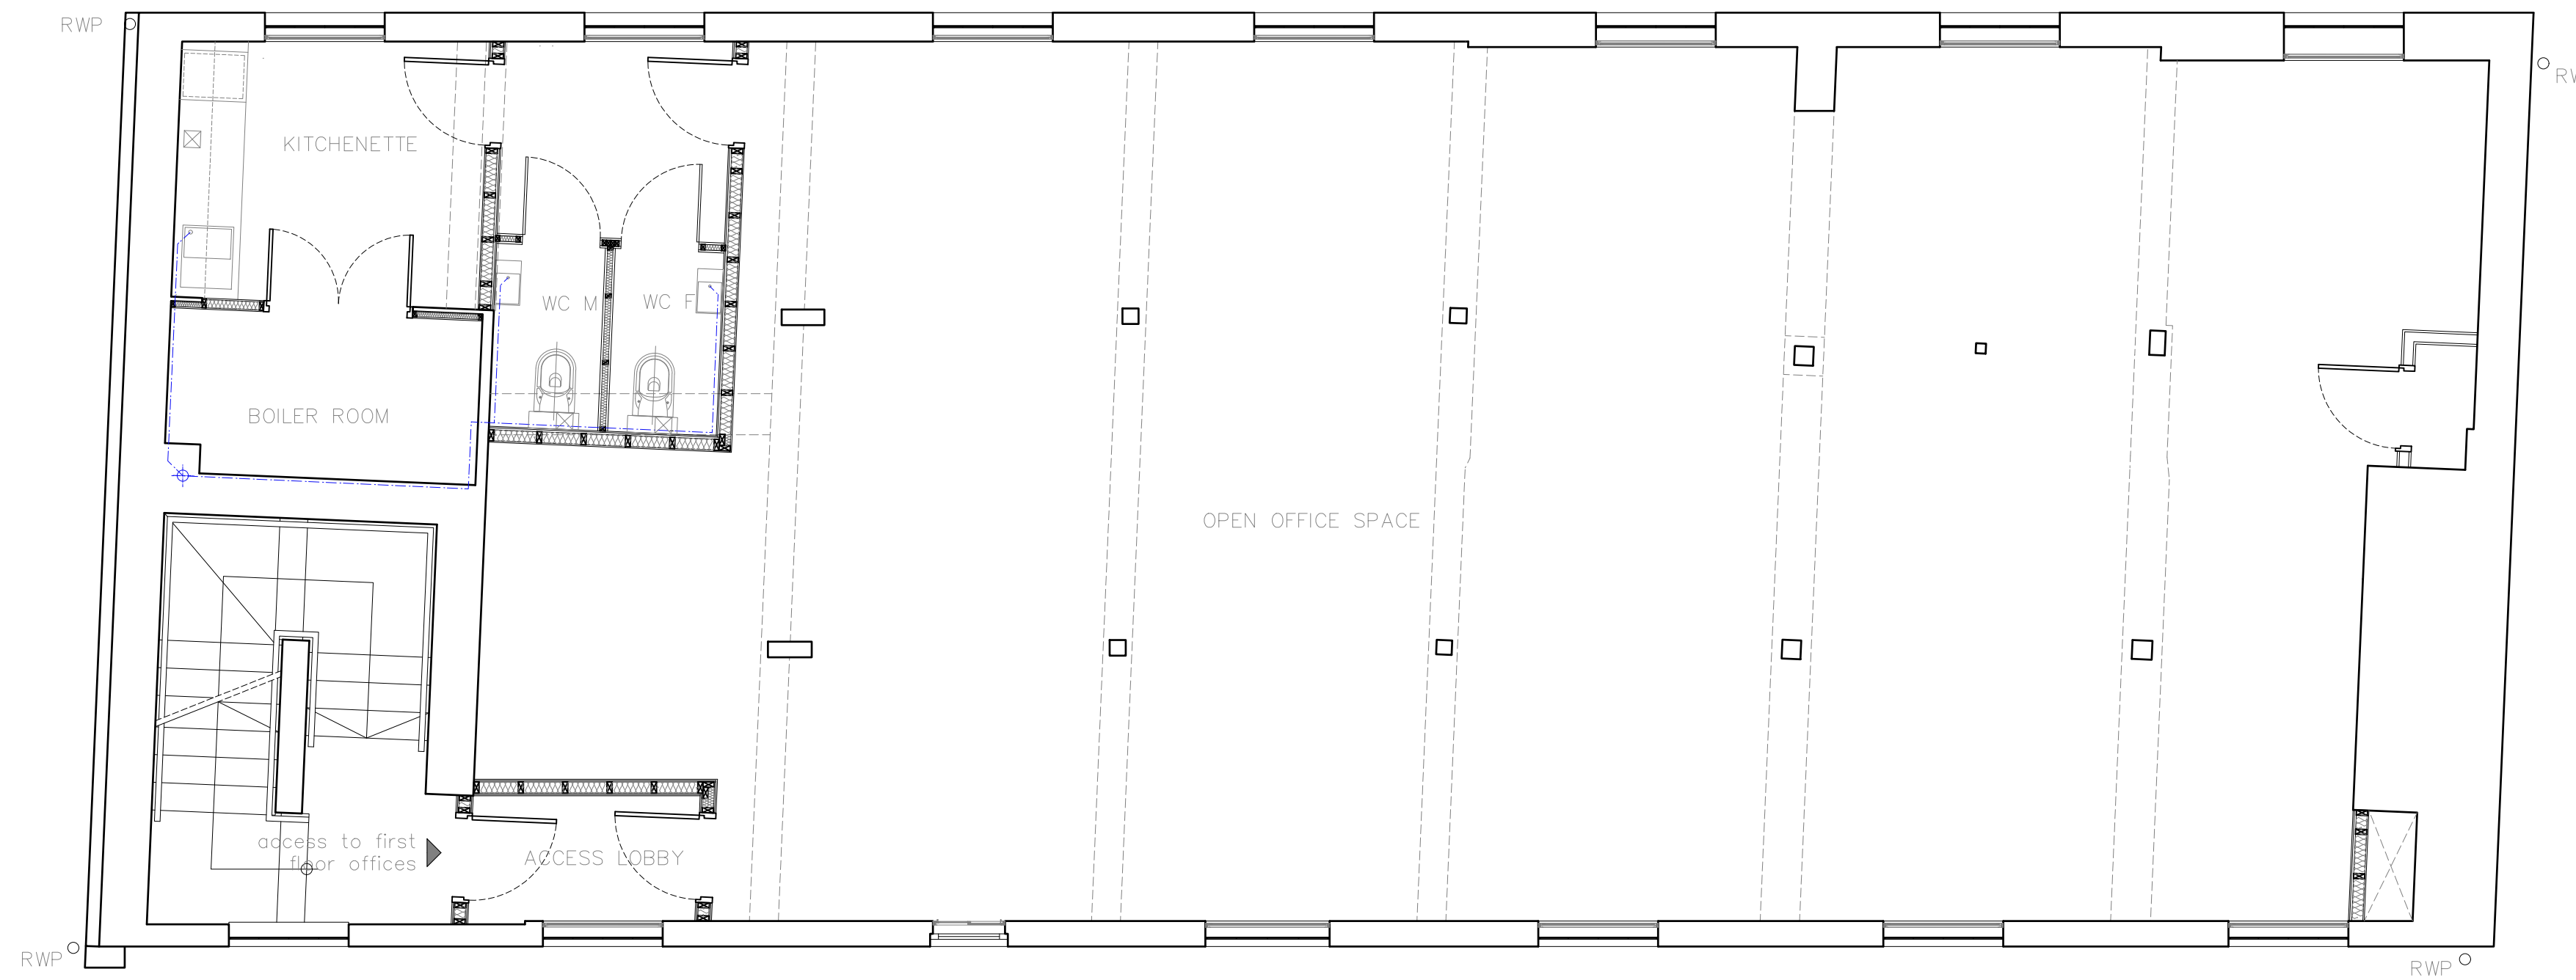


REV	REVISION DETAILS	DATE	DRW	CHK
T1	TENDER MANAGEMENT NOVATED TO KAA	--20	KAA	

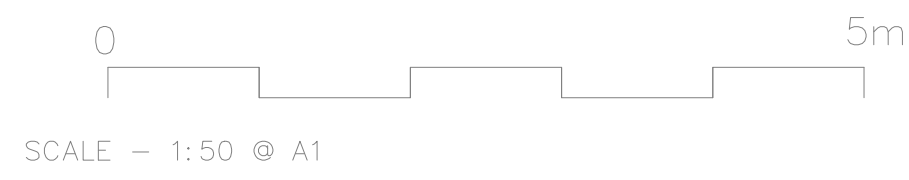

## AS-BUILT DRAWING

PROJECT: THE MALTINGS  
PROJECT ADDRESS: THE MALTINGS, BEAR WHARF, READING, RG1 6BT

CLIENT: MACNIVEN QUAYS LTD  
PROJECT NUMBER: 0074

DRAWING NAME: FIRST FLOOR GA PLAN  
ISSUE TYPE: TENDER

DRAWING NUMBER: 265-W-21

SCALE: 1 : 50  
APPROVED BY: MARENGO PROJECTS

FIRST ISSUE DATE: --  
DRAWN BY: KAA

**General Notes**  
Do not scale from drawings. All dimensions must be checked on site and discrepancies verified with the Architect prior to construction. Unless shown otherwise all dimensions are to be to structural surfaces and are in mm.

Unless shown refer to internal door schedule for door sizes.  
Door openings to be set out to give full specified architrave either side.  
To be read in conjunction with all relevant Architects', Services and Structural Engineers' drawings.

For all structural details and information refer to Structural Engineers drawings.  
For all mechanical and electrical information refer to M&E consultants drawings and information unless shown otherwise.

Any discrepancies between drawings to be reported immediately to the architect as once built on site responsibilities are therefore withdrawn. Refer to drawing number for details and correspondence.

1 FIRST FLOOR GA PLAN  
1:50

**MARENGO**  
PROJECTS

13 The Avenue  
Ealing  
London  
W13 8JR

+44 (0) 845 489 0629  
hello@marengoprojects.com